


Greenberg's Train and Toy Show

August 25-26, 2012

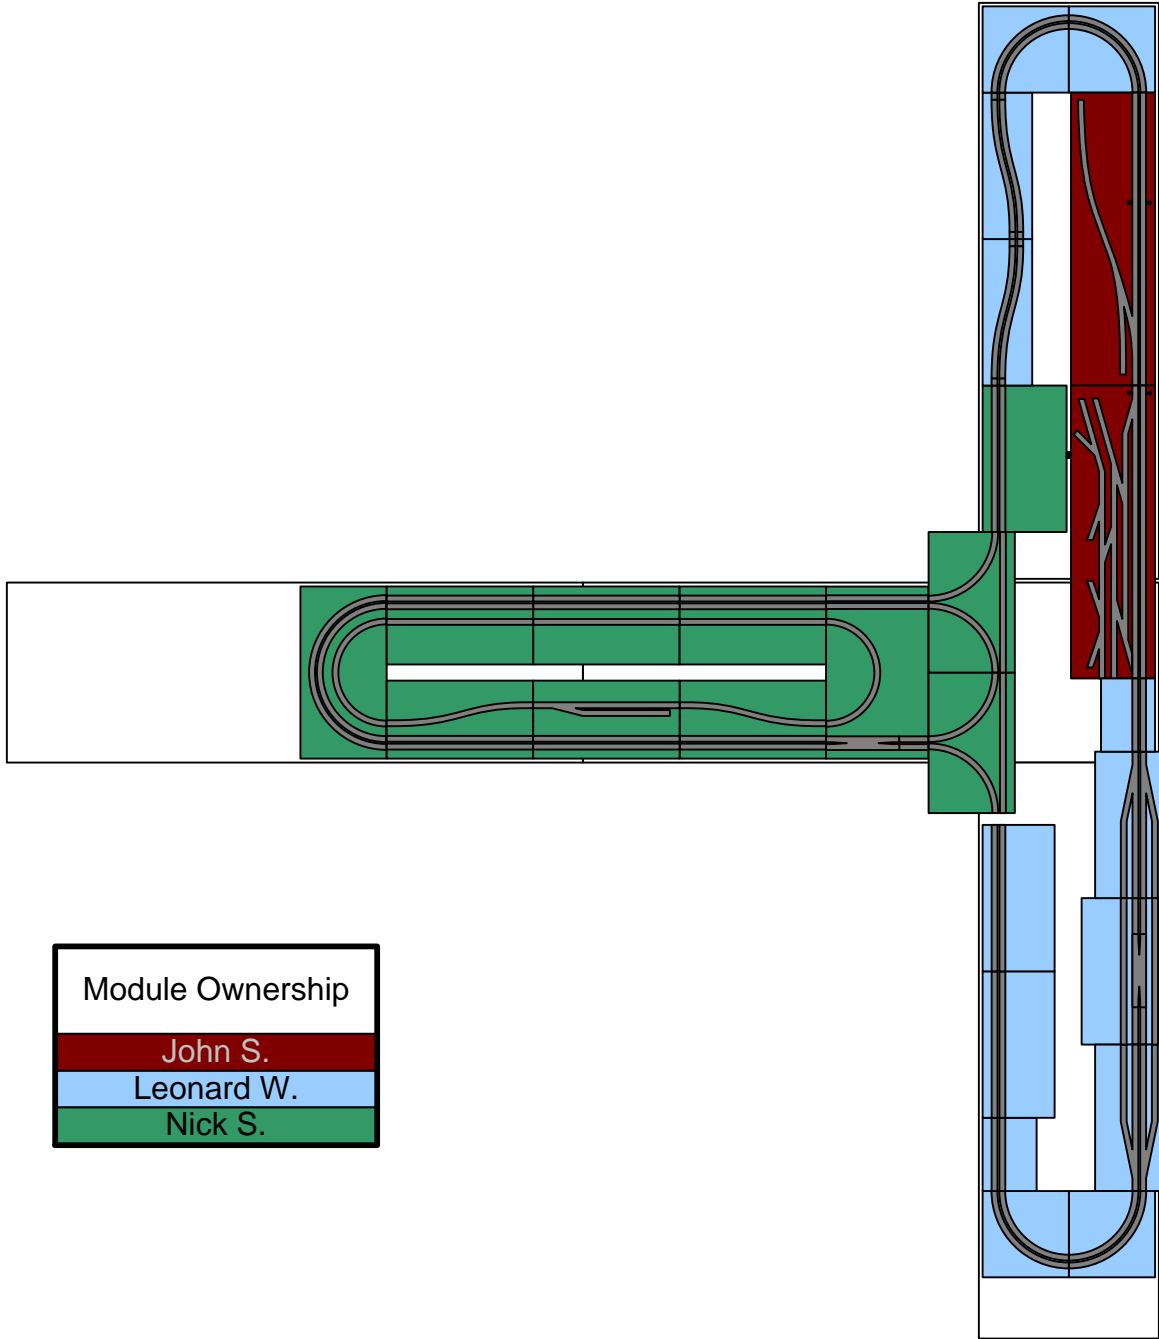

Module Ownership
John S.
Leonard W.
Nick S.