


7th Annual Gaithersburg Model Train Show November 4, 2012



T-TRAK Division

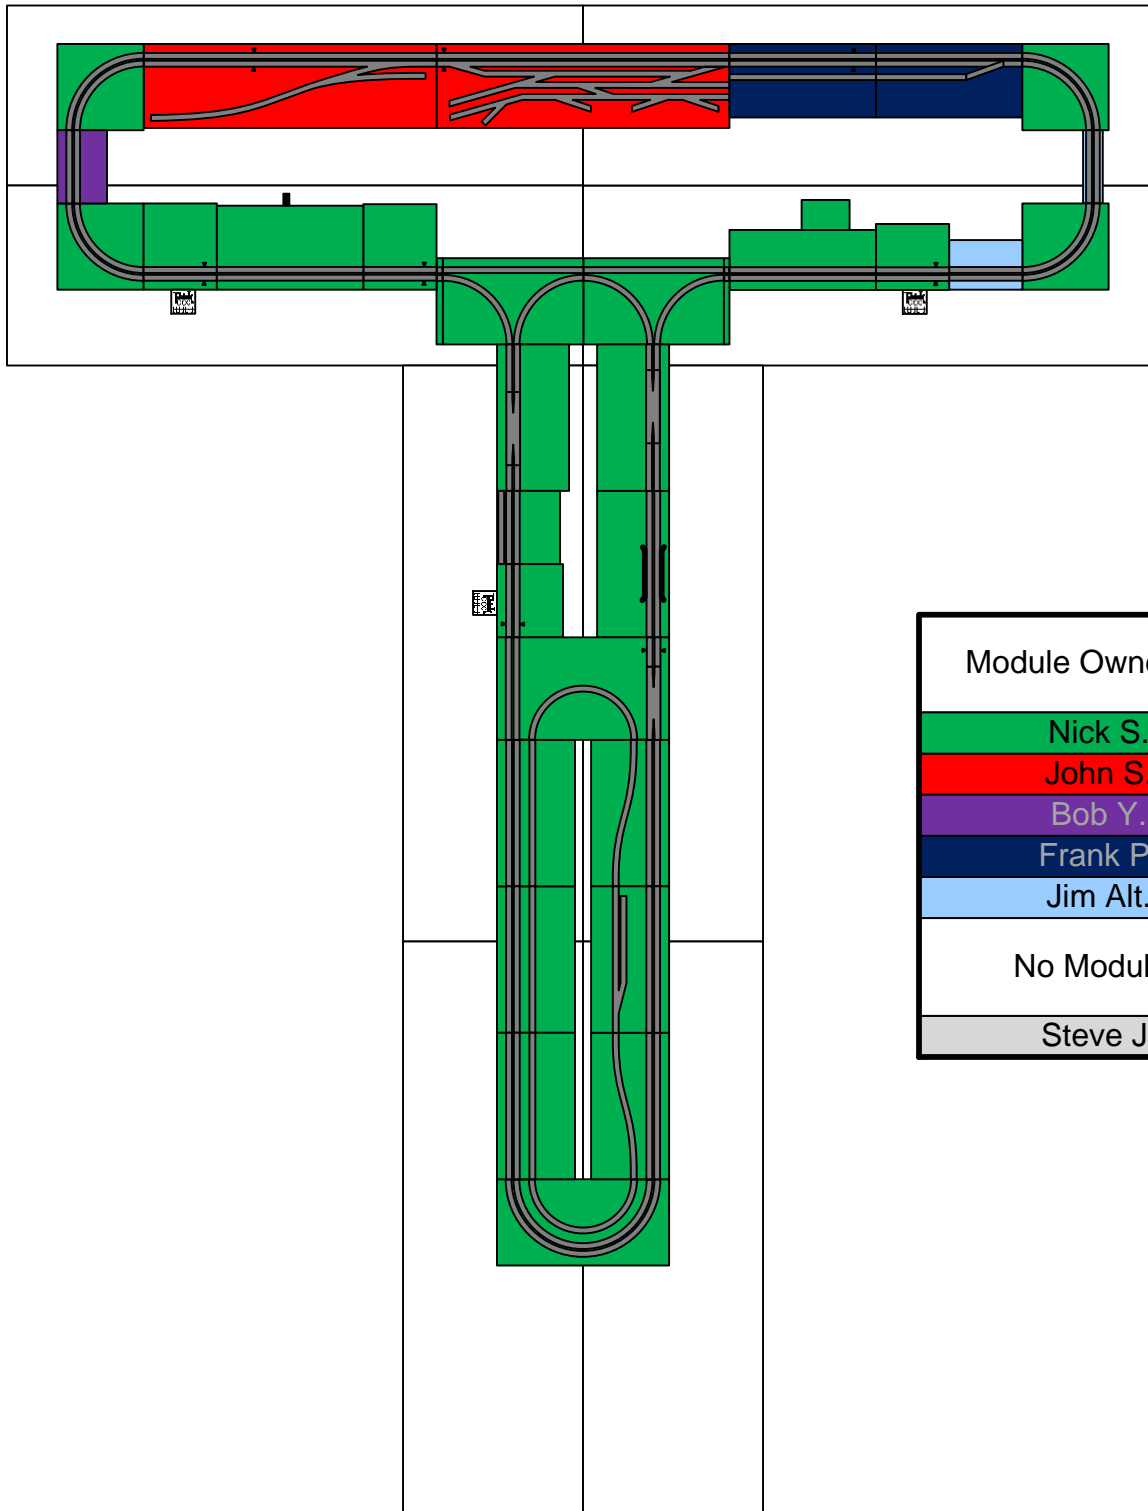

Module Ownership
Nick S.
John S.
Bob Y.
Frank P.
Jim Alt.
No Modules
Steve J.

Drawn by Steve J., 04NOV2012