


62mm "Fire Marshall Bridge"

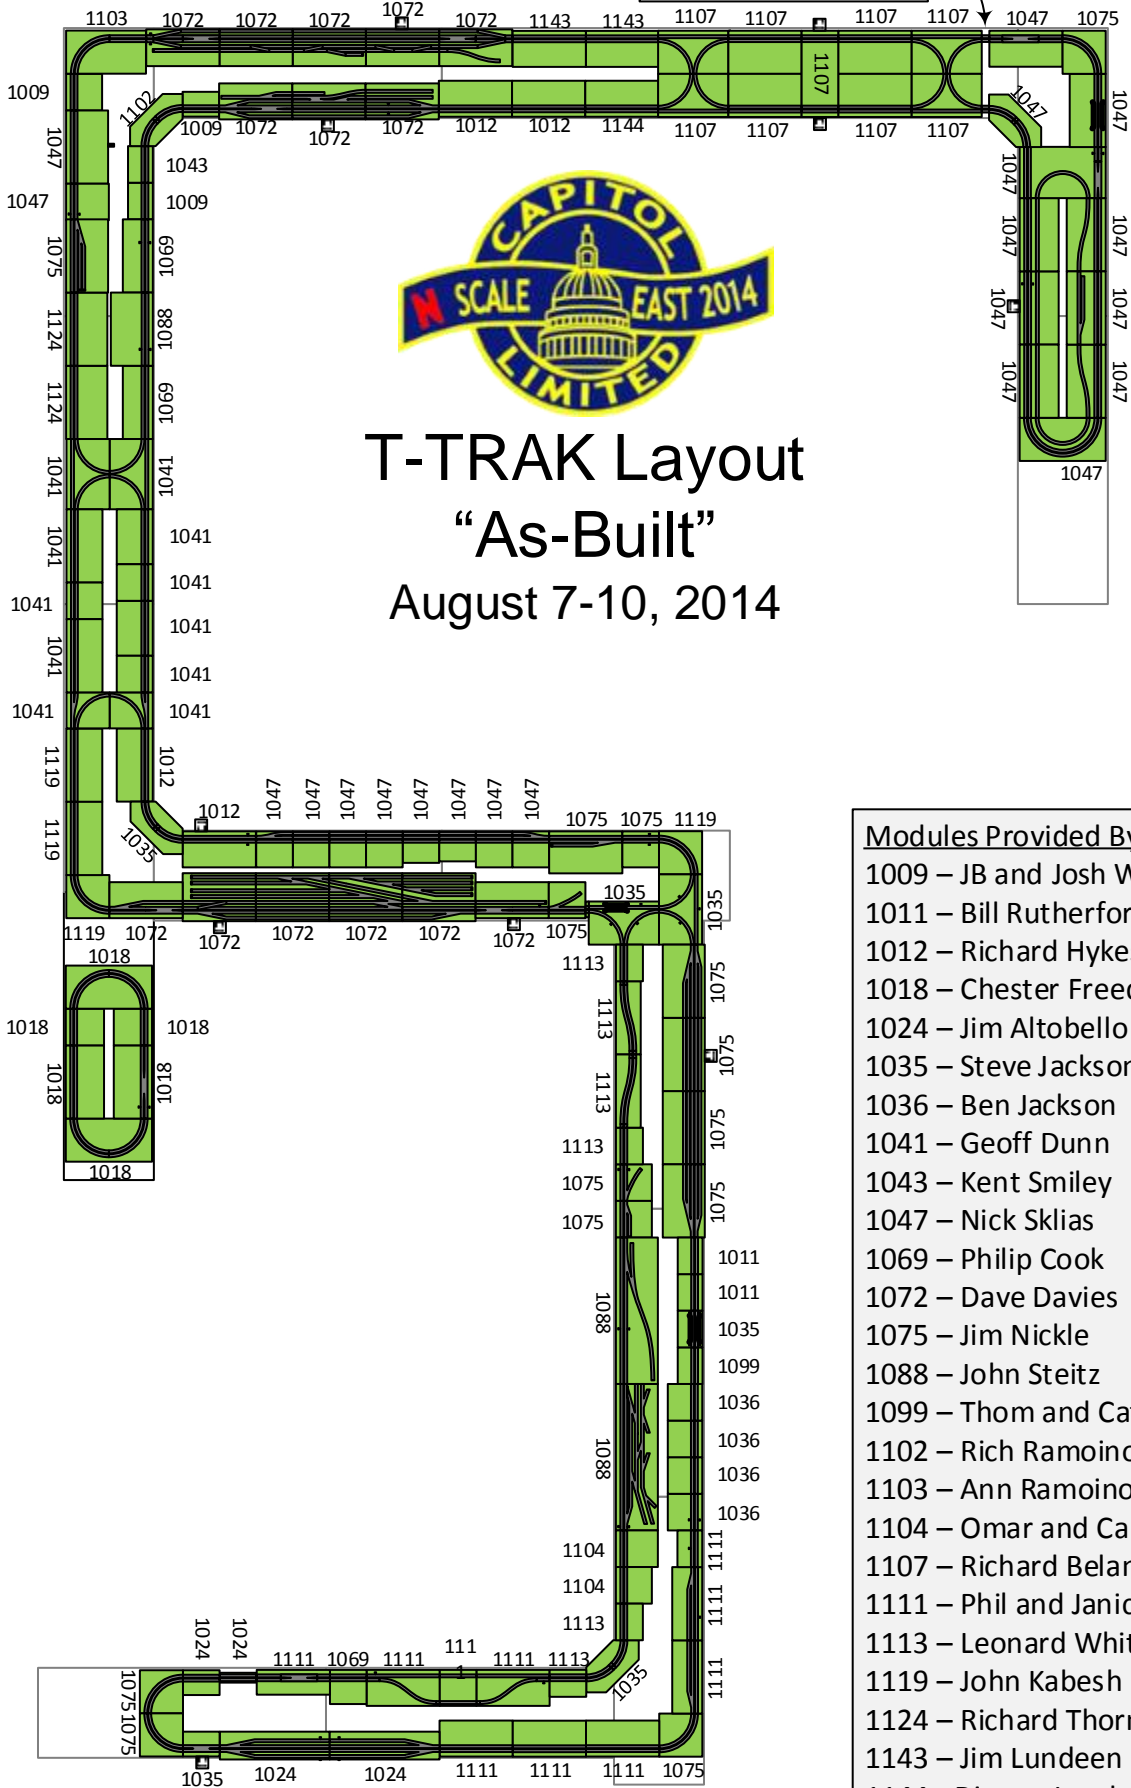

T-TRAK Layout

"As-Built"

August 7-10, 2014

- Modules Provided By:**
- 1009 – JB and Josh Weillepp
 - 1011 – Bill Rutherford
 - 1012 – Richard Hykes
 - 1018 – Chester Freedenthal
 - 1024 – Jim Altobello
 - 1035 – Steve Jackson
 - 1036 – Ben Jackson
 - 1041 – Geoff Dunn
 - 1043 – Kent Smiley
 - 1047 – Nick Sklias
 - 1069 – Philip Cook
 - 1072 – Dave Davies
 - 1075 – Jim Nickle
 - 1088 – John Steitz
 - 1099 – Thom and Cathy Joyce
 - 1102 – Rich Ramoino
 - 1103 – Ann Ramoino
 - 1104 – Omar and Carol Lehr
 - 1107 – Richard Beland
 - 1111 – Phil and Janice Poole
 - 1113 – Leonard White
 - 1119 – John Kabesh
 - 1124 – Richard Thornton
 - 1143 – Jim Lundeen
 - 1144 – Dianne Lundeen