


# Bunker Hill Train Club

## Show & Sale

October 11, 2014



T-TRAK Division

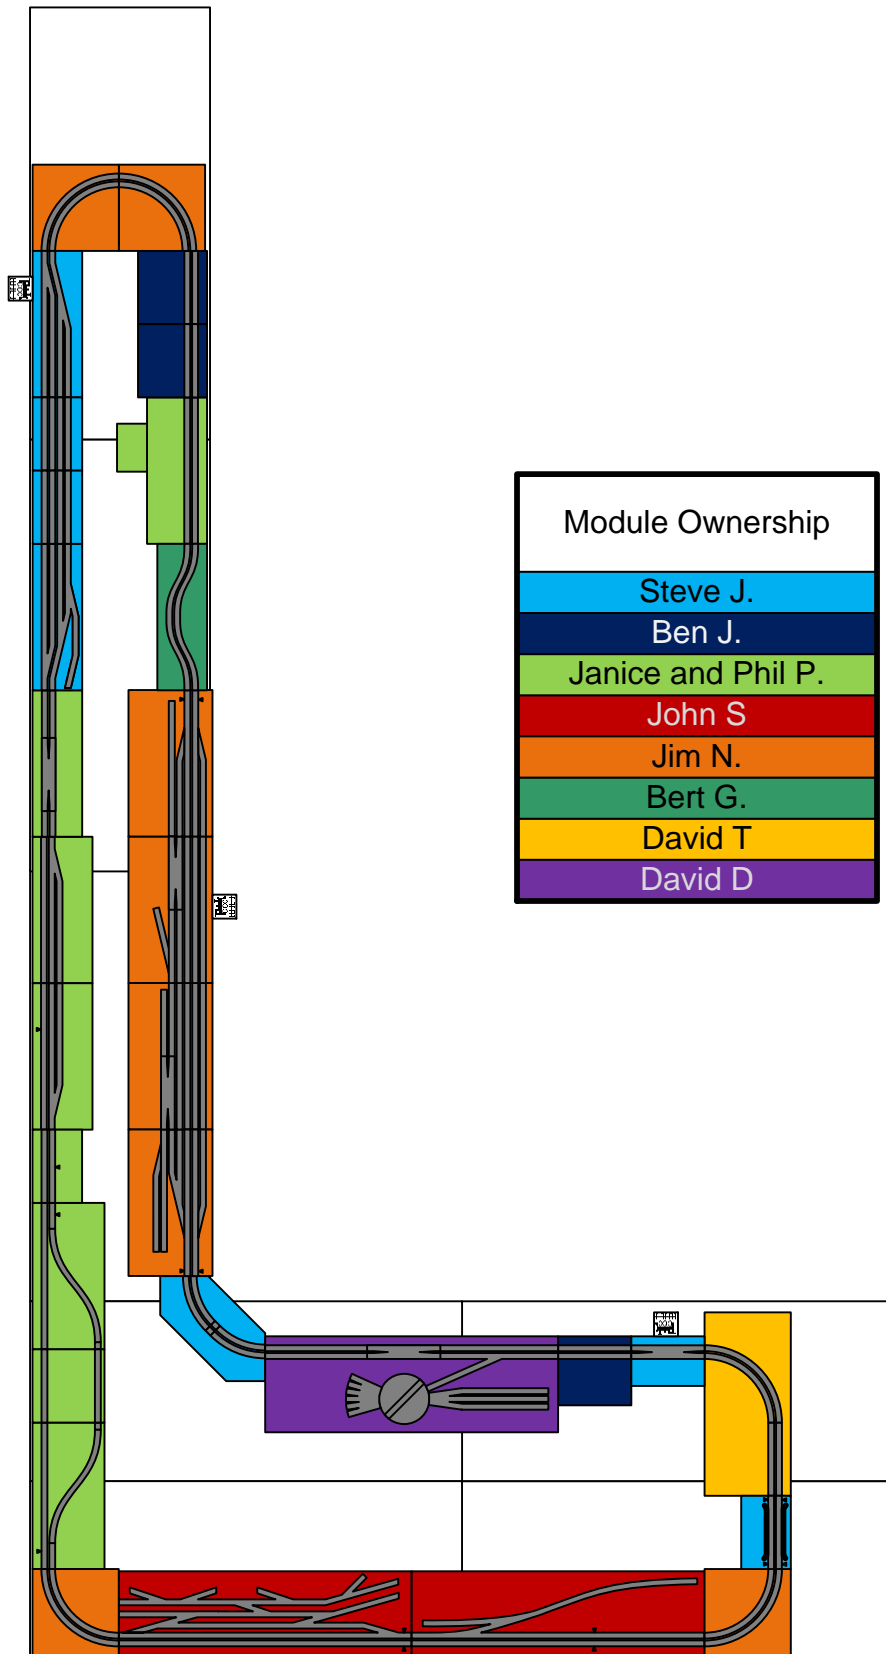

Drawn by Steve J., 12OCT2014