


Fairfax Station

October 12, 2014



T-TRAK Division

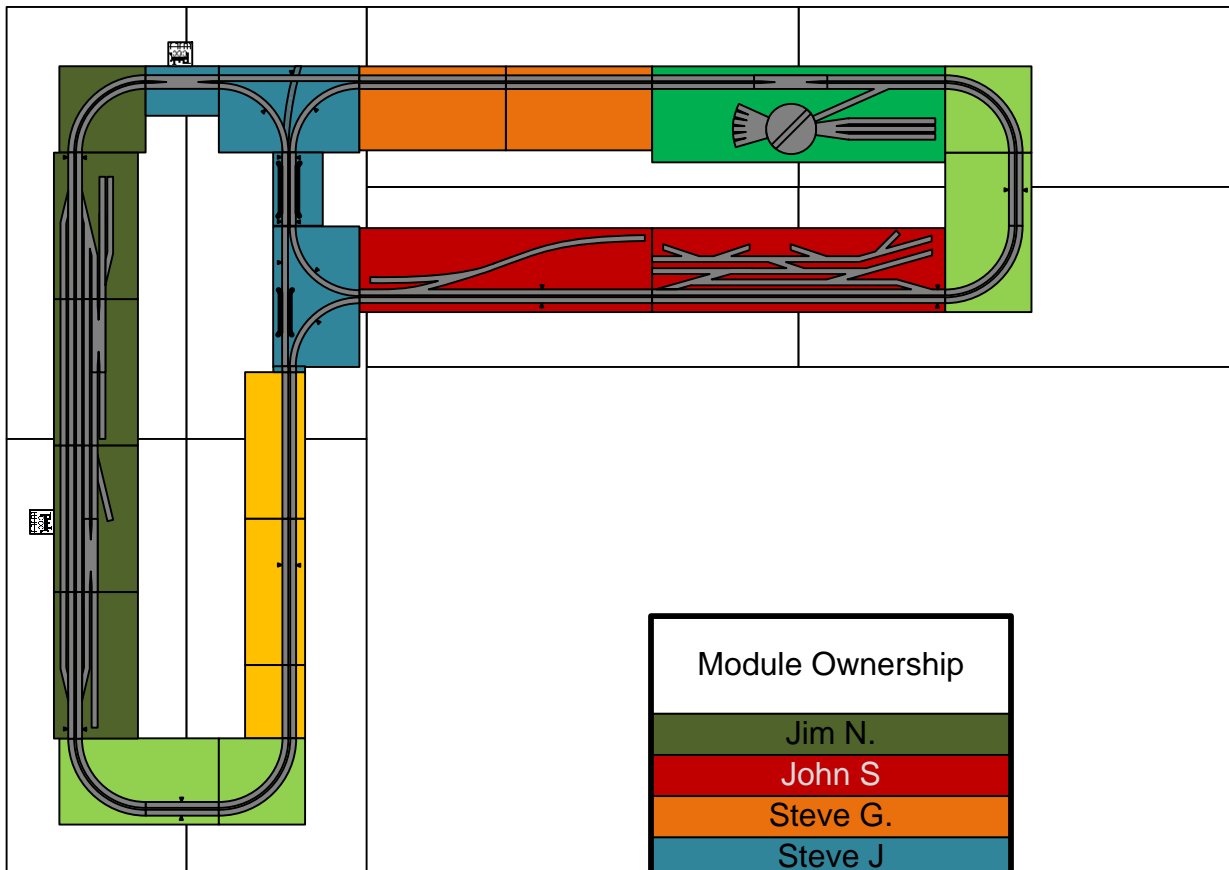

Module Ownership
Jim N.
John S
Steve G.
Steve J
Philip C.
Chester F.
Dave D.