


Bunker Hill Train Club Show

April 1, 2017



T-TRAK Division

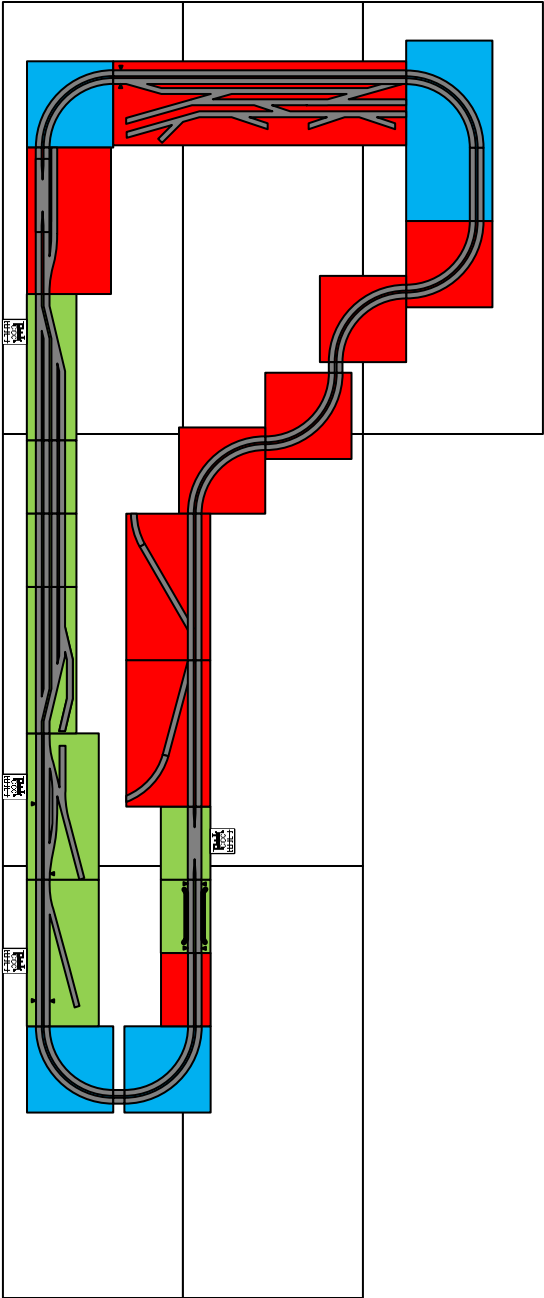

Module Ownership
John S.
Steve J.
David T.