


Fairfax Station

November 10th, 2019

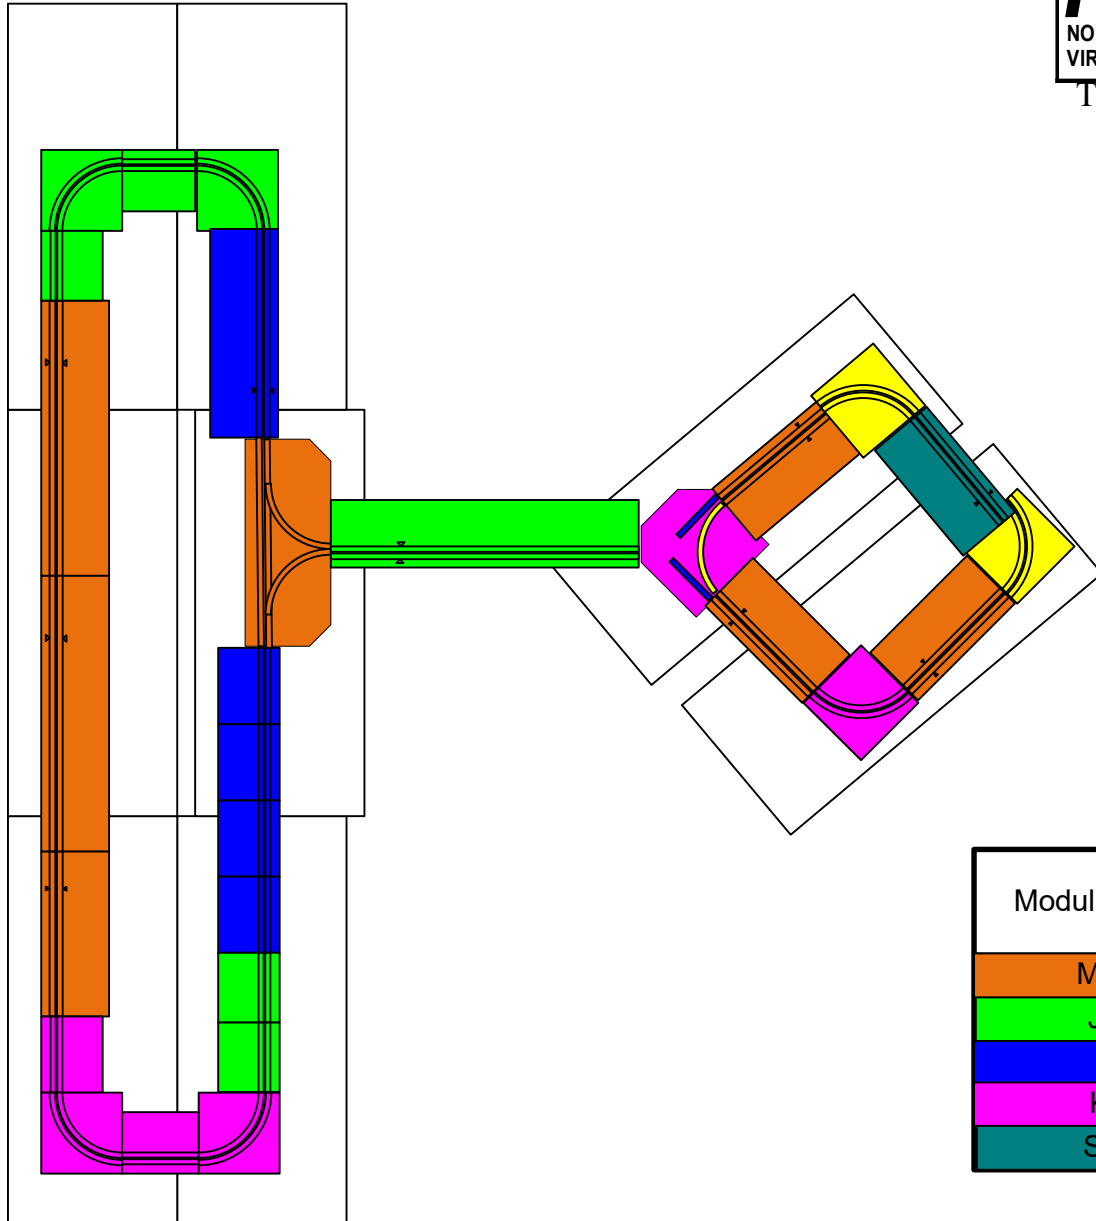

Module Ownership
Matt G-L.
John S.
Jay J.
Kent S.
Steve G.

As-built 191116